

APPLICATION FOR PERMIT SEWER—SEWAGE DISPOSAL 1

COUNTY OF LOS ANGELES
DEPARTMENT OF COUNTY ENGINEER
BUILDING AND SAFETY DIVISION
JOHN A. LAMBIE, County Engineer
CASSATT D. GRIFFIN, Sup't of Building

FOR APPLICANT TO FILL IN

LEGAL DESCRIPTION	LOT NO. <u>24-30-31</u>	
BLOCK	TRACT <u>14758</u>	
SIZE OF LOT	NO. OF BLDGS. NOW ON LOT <u>1</u>	
USE OF BUILDINGS	<u>Church</u>	
CONTRACTOR	<u>7 Avelley Pblg.</u>	
ADDRESS	<u>904 W. W. Little Blvd</u>	
CITY	<u>Montebello</u> TEL. NO. <u>PA 1-1336</u>	
REGISTRATION NO.	<u>105629 SC42</u> STATE COUNTY	
NO.	DESCRIPTION OF WORK	FEE
<u>1</u>	HOUSE SEWER CONNECTING TO PUBLIC SEWER	@ \$3.00 <u>3 00</u>
	SEPTIC TANK, SEEPAGE PIT OR PITS AND/OR DRAINFIELD	@ \$3.00
	OVERFLOW SEEPAGE PIT, DRAINFIELD EXTN., CESSPOOL, DRYWELL	@ \$2.00
	HOUSE SEWER CONNECTING TO PRIVATE DISPOSAL SYSTEM	@ \$1.00
	CONNECT ADDITIONAL BLDG. OR WORK TO HOUSE SEWER	@ \$1.00
	ALTER, REPAIR OR ABANDON HOUSE SEWER OR DISPOSAL SYSTEM	@ \$1.00

OWNER'S AUTHORIZATION	PERMIT	\$ <u>2 00</u>
	TOTAL FEE	<u>5 00</u>

I HAVE AT THIS DATE A CONTRACT WITH THE HEREIN NAMED CONTRACTOR TO CONNECT THE ABOVE DESCRIBED EXISTING DWELLING TO THE PUBLIC SEWER.

SIGNED THIS DAY OF 19

OWNER OR OWNERS AGENT Alfred Work

ADDRESS _____

I HEREBY ACKNOWLEDGE THAT I HAVE READ THIS APPLICATION AND STATE THAT THE ABOVE IS CORRECT AND AGREE TO COMPLY WITH ALL COUNTY ORDINANCES AND STATE LAWS REGULATING PLUMBING AND SEWERS.

I HEREBY CERTIFY THAT I AM PROPERLY REGISTERED AND/OR LICENSED AS REQUIRED BY LOS ANGELES COUNTY AND STATE OF CALIFORNIA OR THAT I AM THE LEGAL OWNER OF THE ABOVE DESCRIBED RESIDENTIAL PROPERTY.

SIGNATURE OF PERMITTEE 7 Avelley

BUILDING ADDRESS	<u>5400 E. Pomona Blvd</u>		
LOCALITY	<u>Montebello La County</u>		
NEAREST CROSS ST.	<u>Hilbroad</u>		
OWNER	<u>Luther Church</u>		
MAIL ADDRESS	<u>Same</u>		
CITY	TEL. NO.		
DISTRICT NO.	GROUP	BK MAP PG	PROCESSED BY
<u>6</u>	<u>F</u>	<u>M 46</u>	<u>Jefferts</u>
CONNECTION DATA			
STATION	<u>0+43.5</u>		DEPTH <u>6'</u>
MANHOLE REFERENCE	<u>43.560</u>		UPPER LOWER
TYPE OF CONNECTION		LENGTH FROM	
<u>(F) CURB</u> <u>(P.L.)</u>		M.L. TO P.L.	
<u>alley</u>			
CO. IMP. NO.	P.C. NO. <u>876</u>		
TRUNK PERMIT NO.		ROAD PERMIT NO.	
STATE ENCROACHMENT PERMIT NO.			
INDUSTRIAL WASTE APPROVAL			
CHARGES			
CONNECTION CHARGE FEE			
REIMBURSEMENT FEE			
APPROVALS		DATE	INSPECTOR'S SIGNATURE
NEW HOUSE SEWER		<u>11-9-60</u>	<u>FLTHW</u>
CONNECT ADDITIONAL BUILDING OR WORK			
SEPTIC TANK, SEEP. PIT(S) AND/OR DRAINFIELD			
CESSPOOL <input type="checkbox"/> DRYWELL <input type="checkbox"/>			
ALTER, REPAIR, SEWER OR SEWAGE DISPOSAL SYSTEM			
DISCONNECT PLUG AND ABANDON HOUSE SEWER			
BACKFILL SEPTIC TANKS <input type="checkbox"/> SEEP. PIT(S) <input type="checkbox"/> CESSPOOLS <input type="checkbox"/>			

VALIDATION

CK

M. O.

CASH

ROBERT A. WOOD
SUPERVISING MECHANICAL ENGINEER

LAC 50668 NOV 9 10 A 5.00 35


Jefferts

FOR DEPARTMENT USE

REQUIRED INFORMATION

1. INDICATE ALL BUILDINGS ON PROPERTY.
2. INDICATE AND DIMENSION SEWAGE DISPOSAL SYSTEM WITH TIE DISTANCES TO BUILDINGS AND PROPERTY LINES.
3. INDICATE SIZE OF SEPTIC TANK—DEPTH OF SEEPAGE PIT(S)—SIZE OF CESSPOOL(S).
4. INDICATE NORTH DIRECTION ON PLOT.
5. INDICATE BOTH STREETS IF CORNER.

320 000
1.
226000

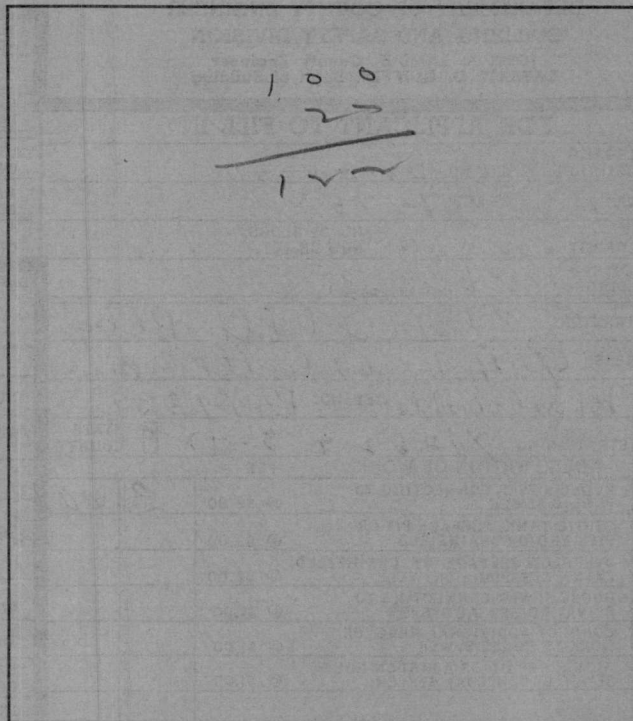

ST. ALLEY R/W

FIELD NOTES